


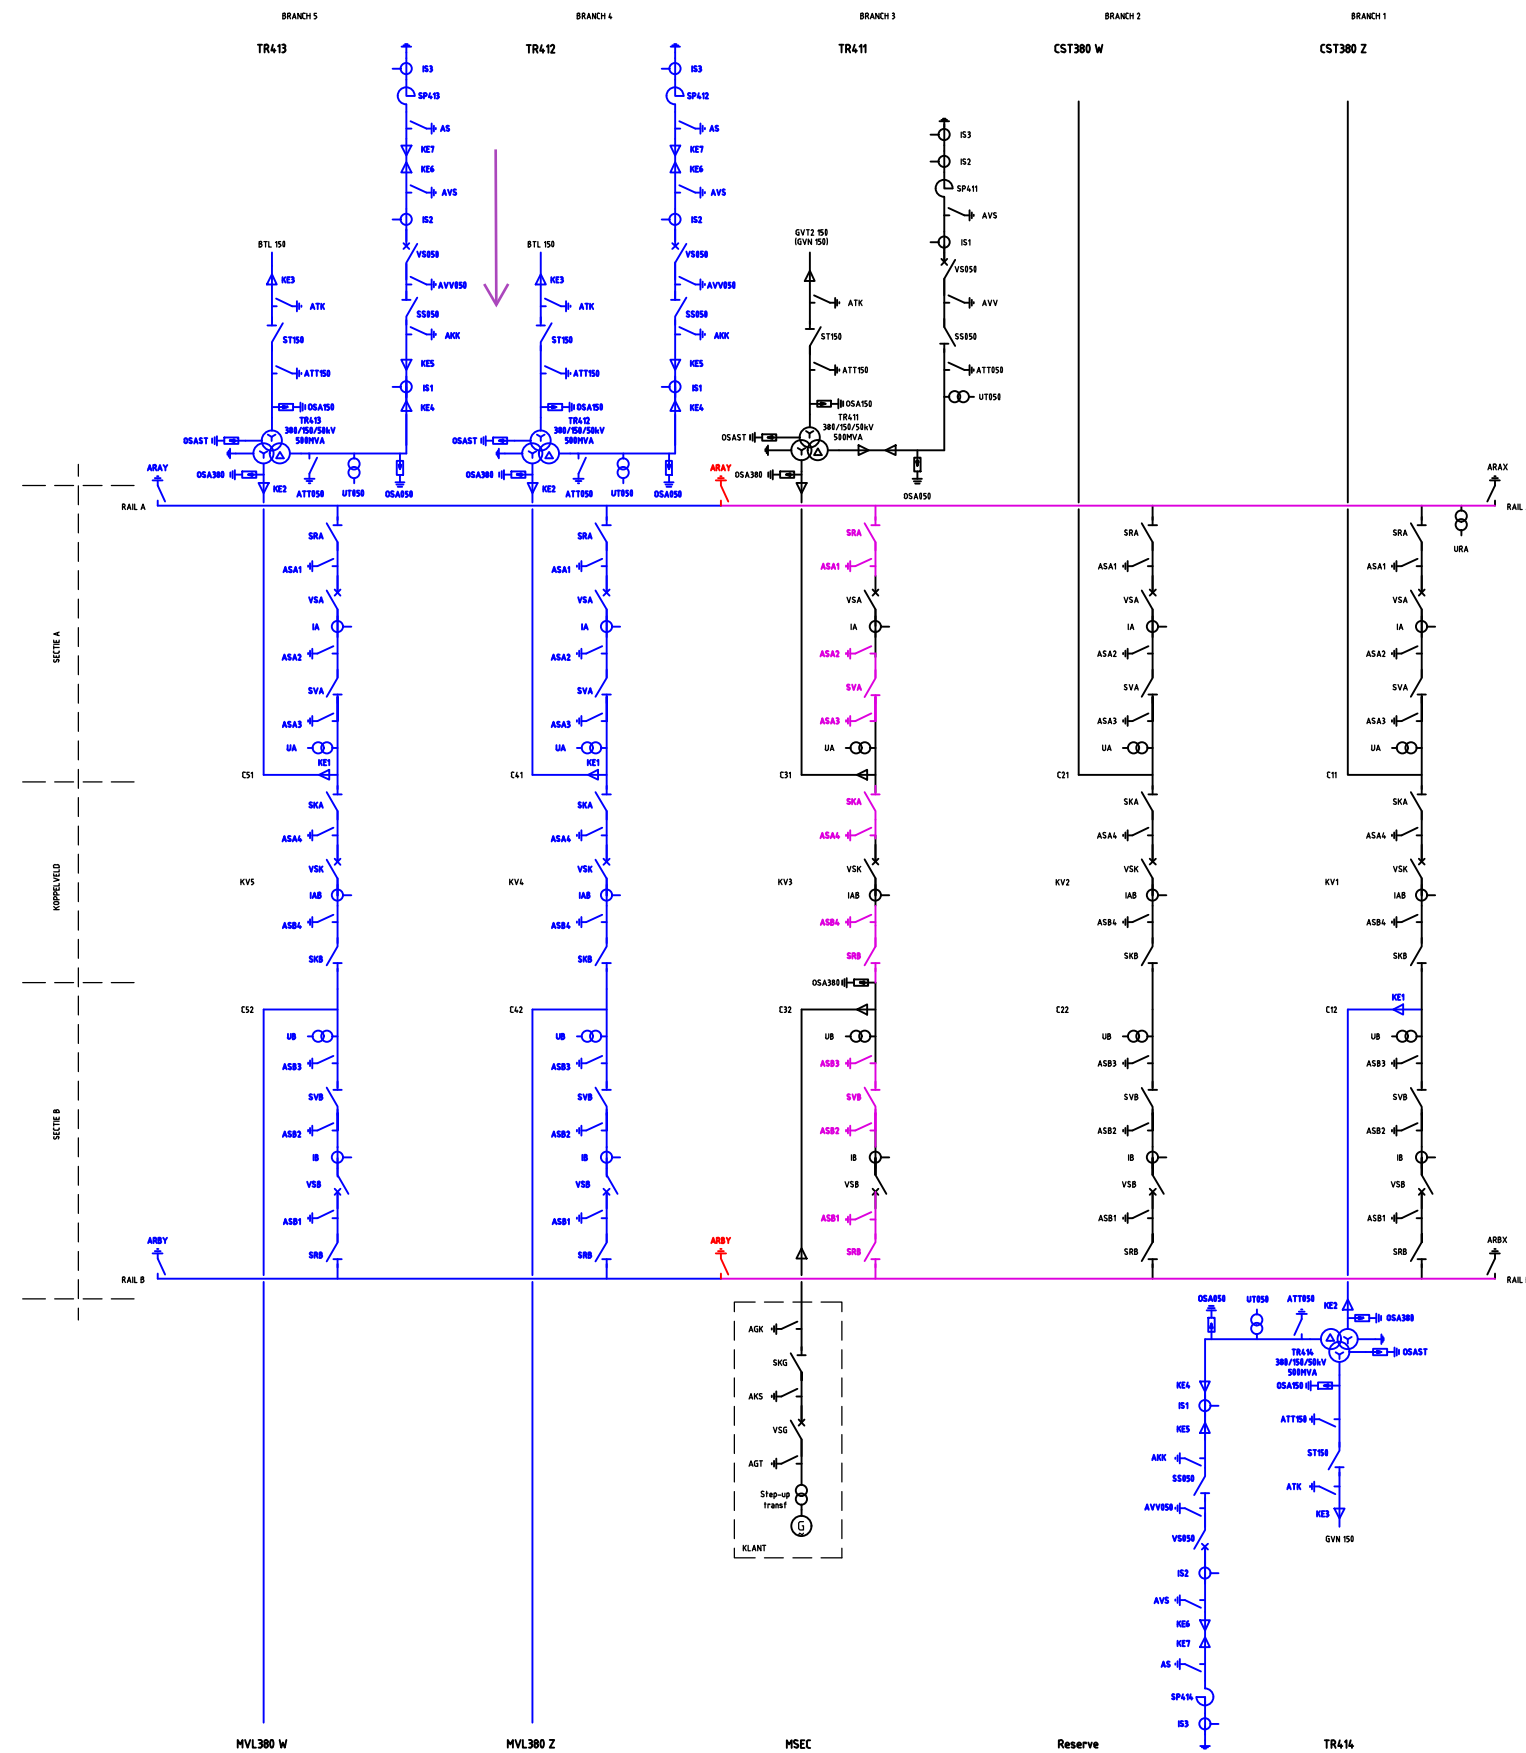

- LEGEND (Name Symbol = Name Block)
- Transformer
 - Transformer - Star-Delta
 - Transformer Star-Delta
 - Transformer 1
 - Regulator
 - Compensation Reactor
 - Combi-Transformer
 - Current Transformer
 - Voltage Transformer
 - Current Transformer Star Point
 - Circuit Breaker
 - Disconnect Switch
 - Earthing Switch
 - Earthing (Loose)
 - Cable Termination
 - Cable Bushing
 - Surge Arrester
 - Generator
- NEW
REMOVE
REMOVE AND REPLACE
EXISTING

003.215.40
UAV-GC VS1 APPENDIX P13

Name Station Simonshaven 380				Drawing Status V00R VS1				
Relation	Rev.	Rev. Date	Rev. Description	Drawn By:	Date As-Built	Scale	Format	Object ID
	1.0	17-01-2024		JGN - TenneT		1:1	A3	SMH380
				Theme	Primair		Description:	
				Category	Schema		SMH380 PHASE 2-4 SINGLE LINE DIAGRAM STATION - SCOPE	
				Documentcode	Grondschem		Document number:	
Old Drawing Number							BO-01350-04-152	